
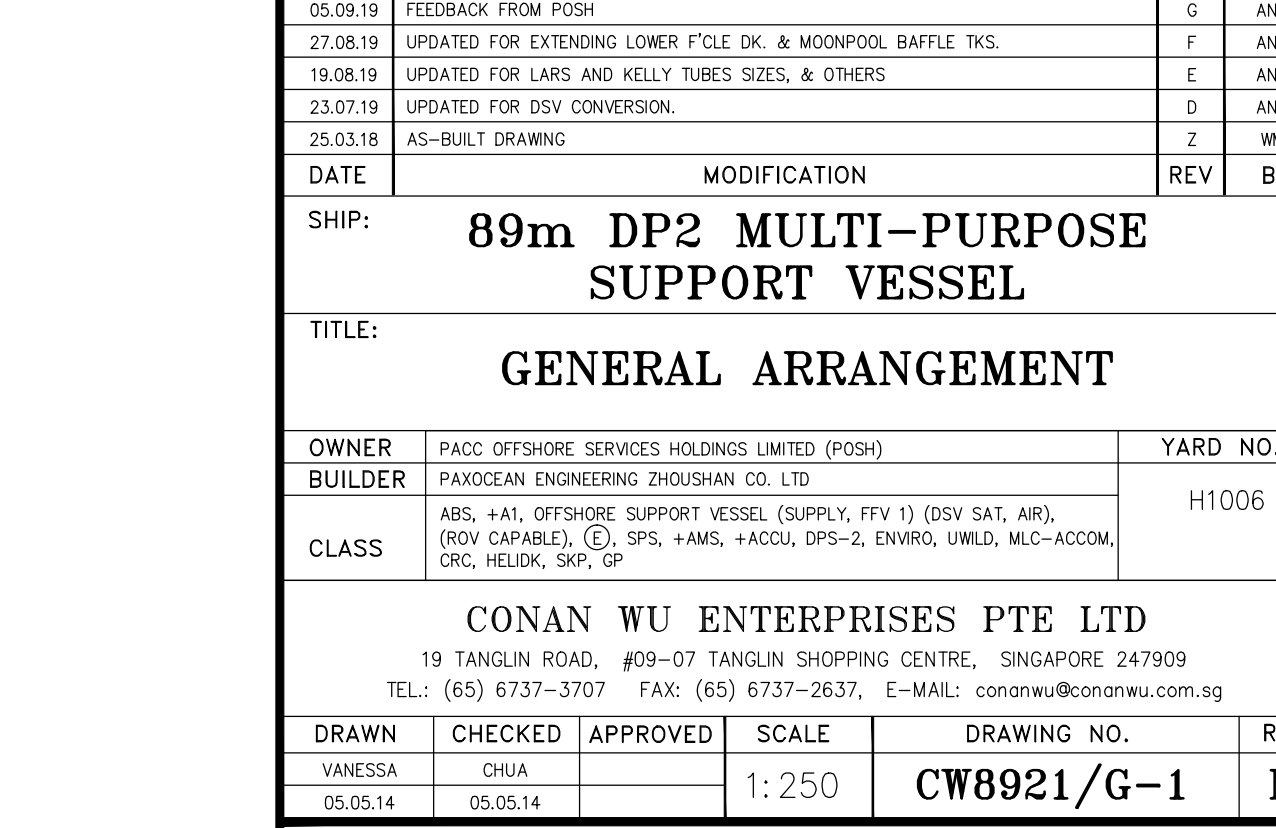
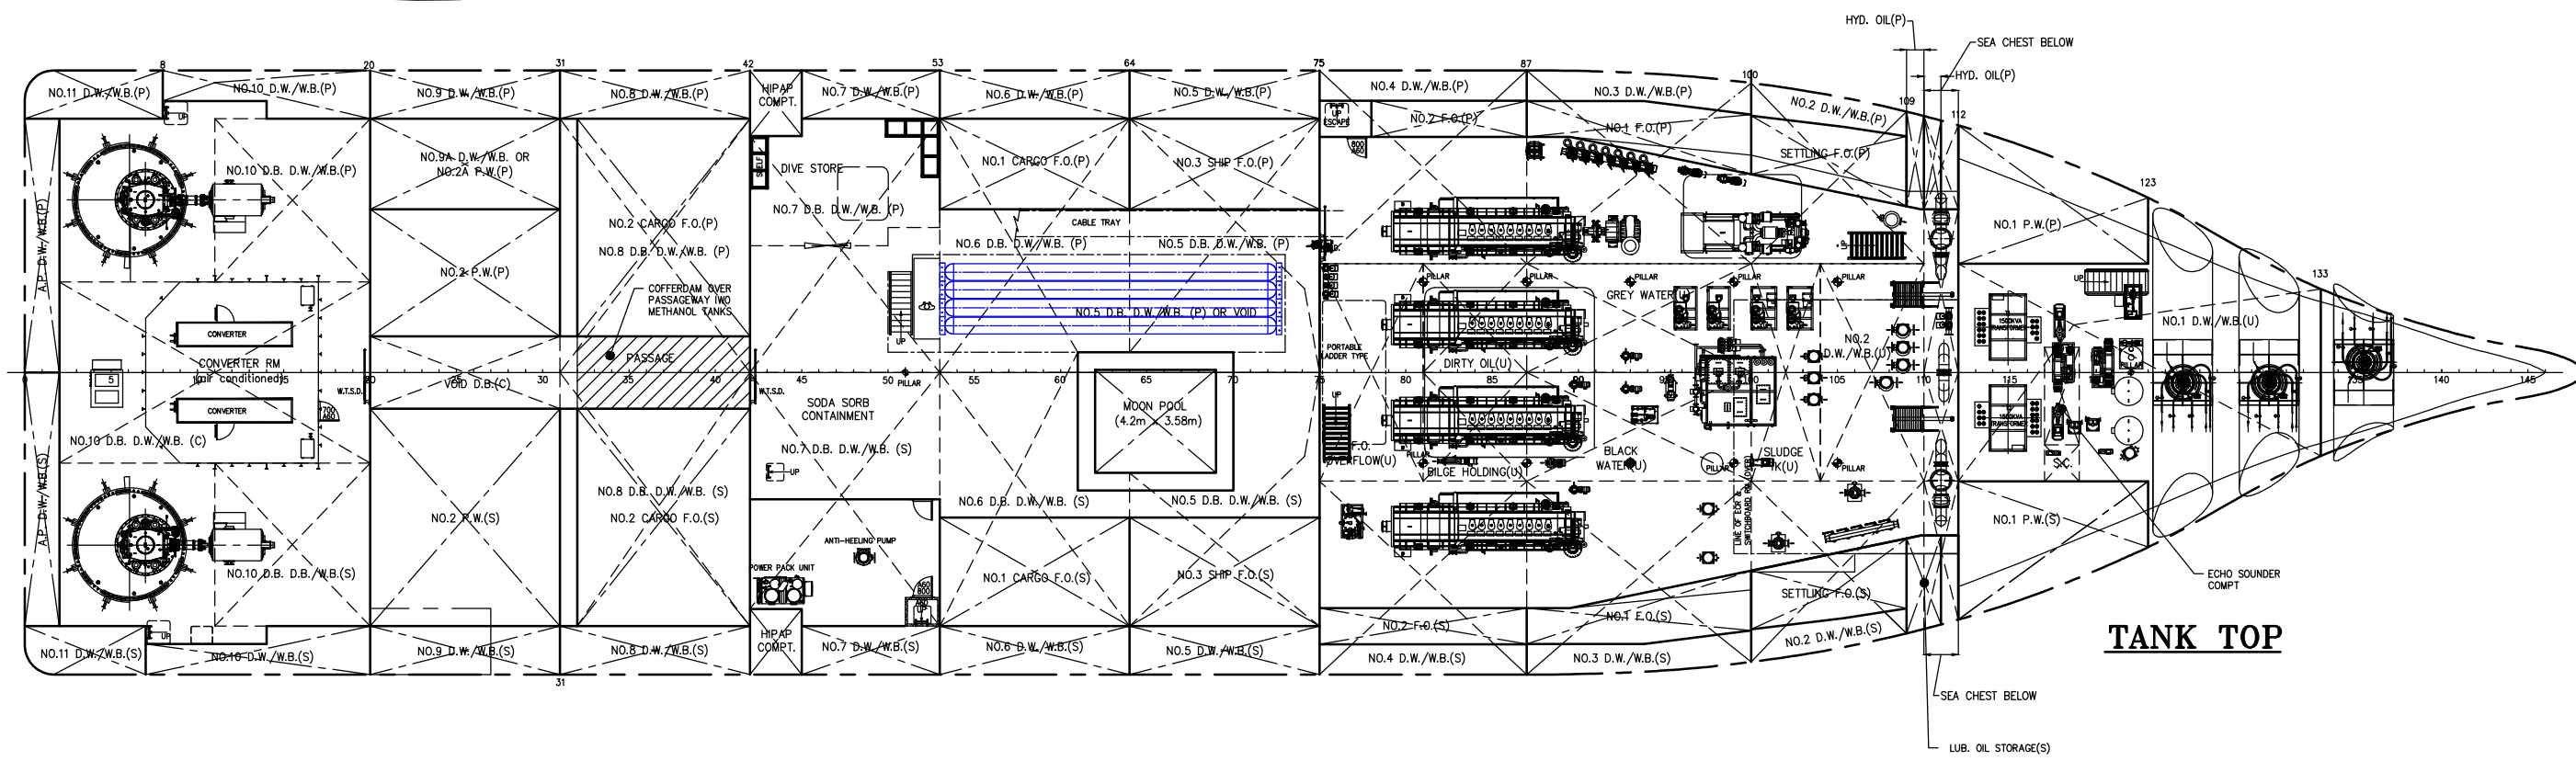
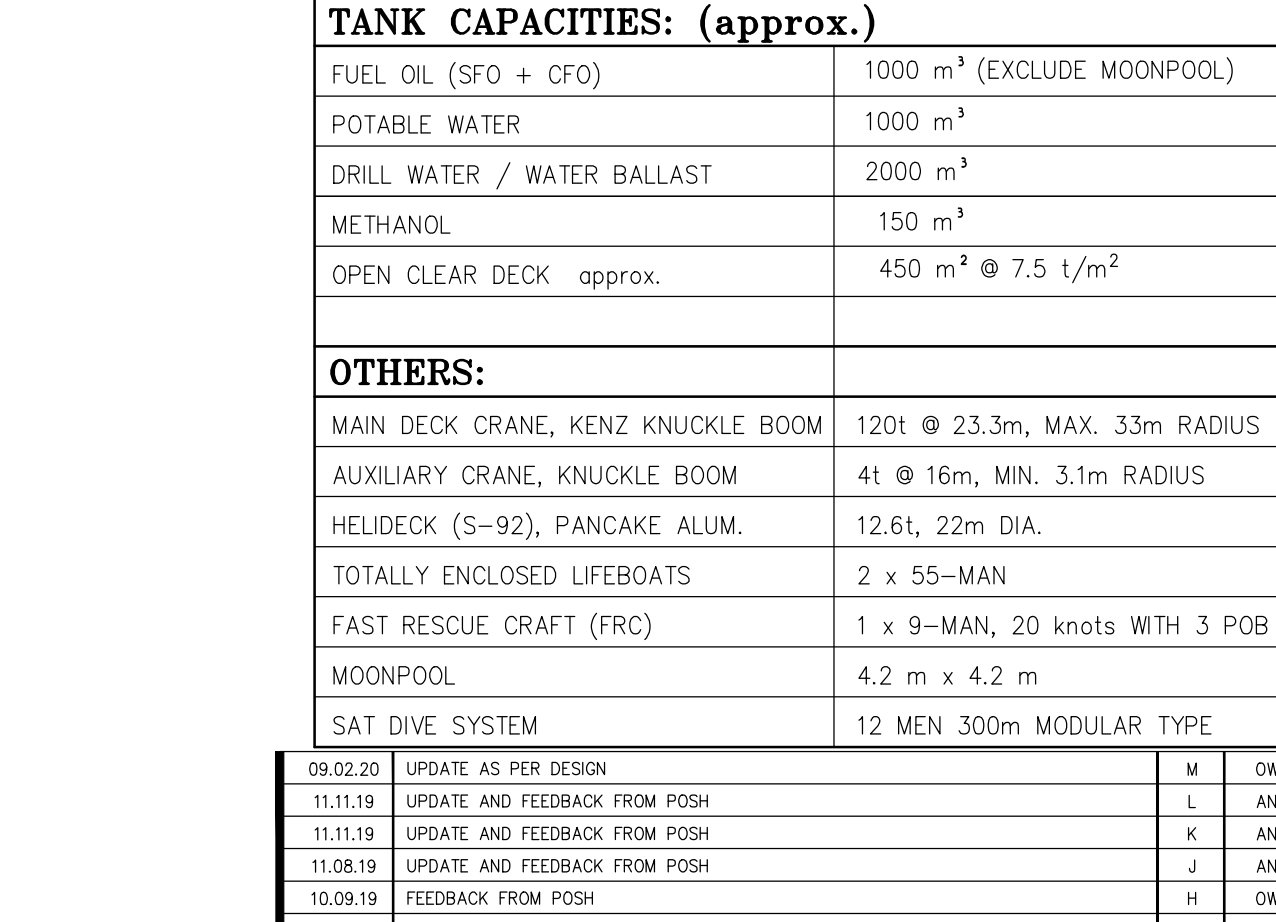
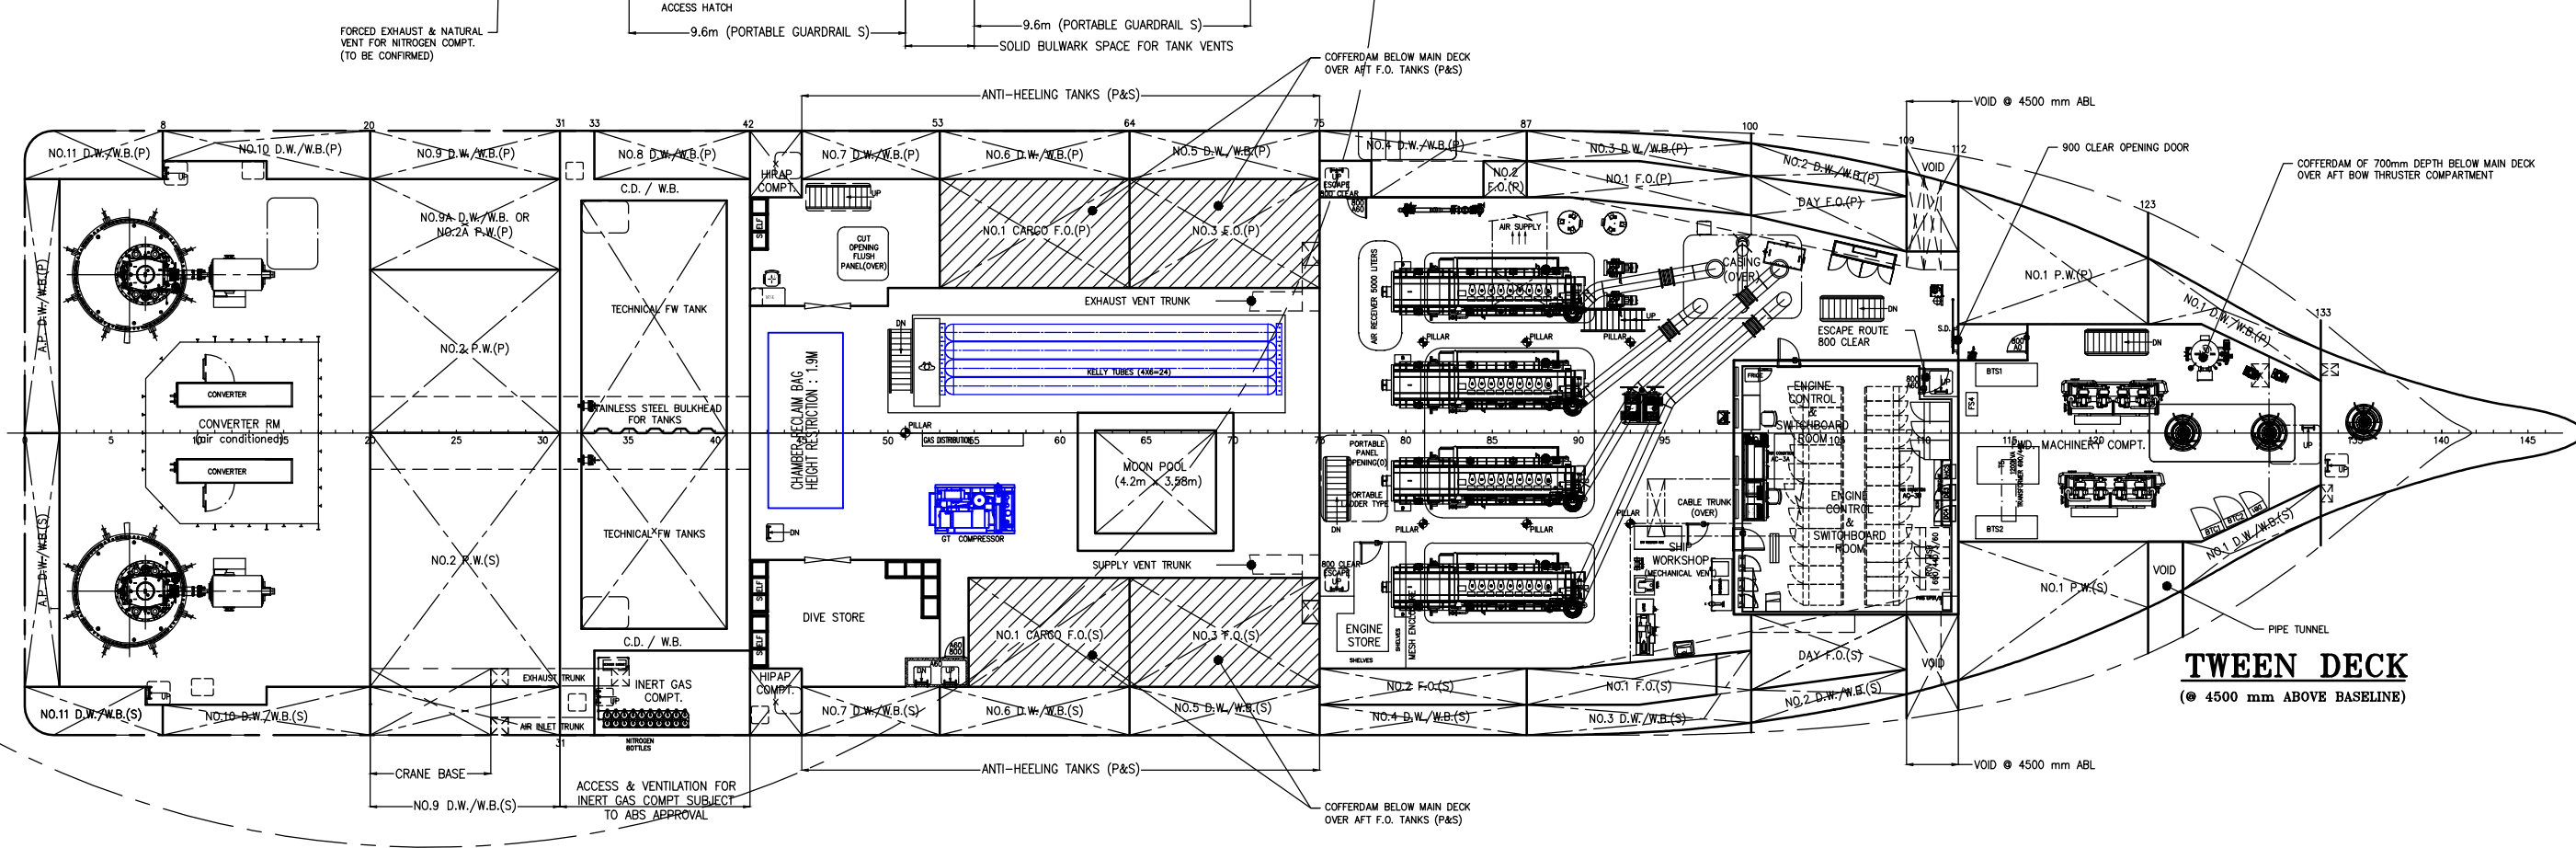
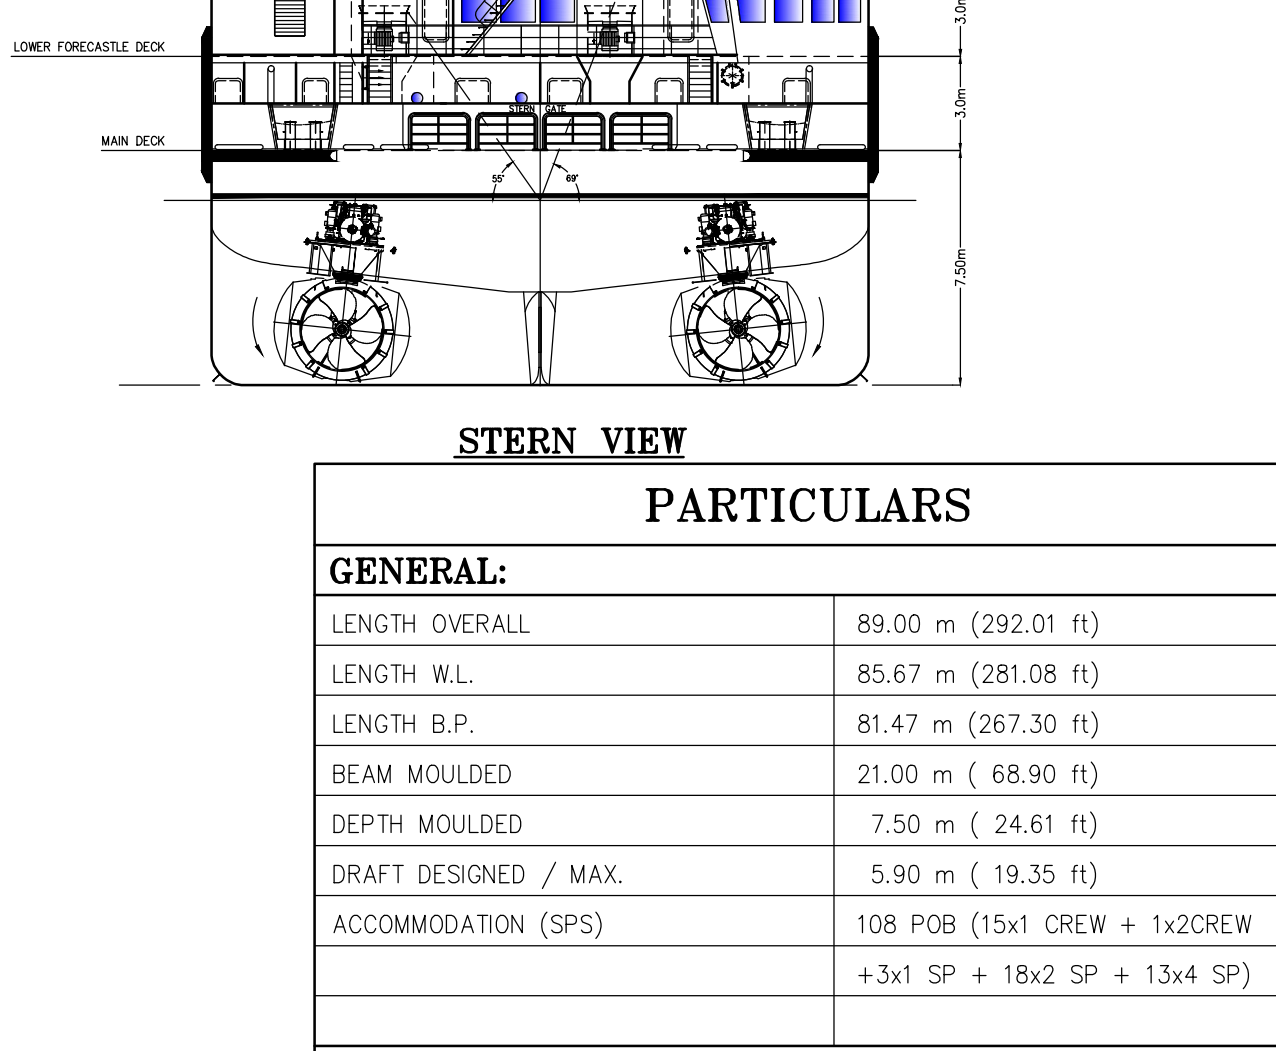
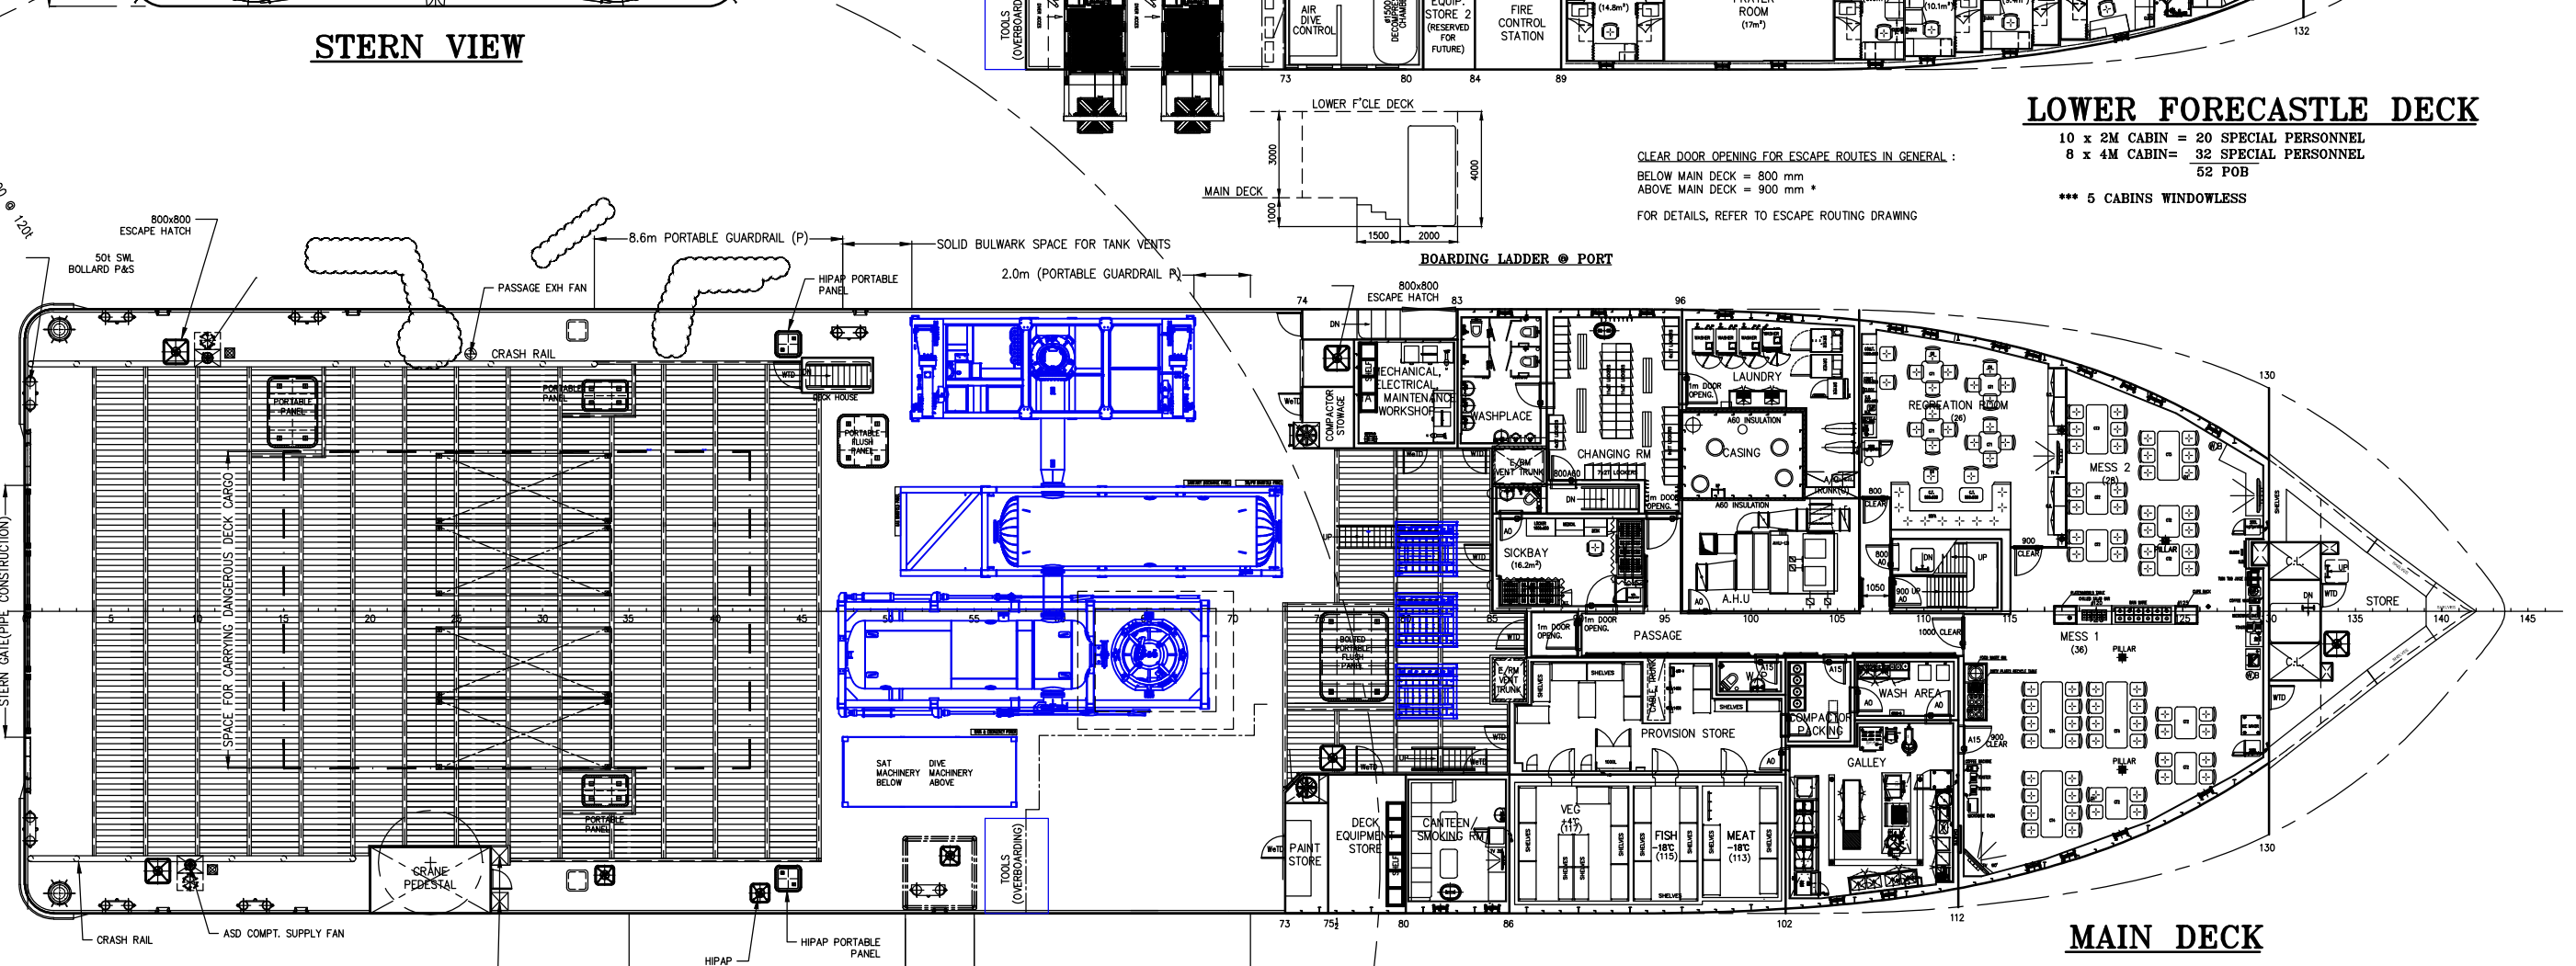
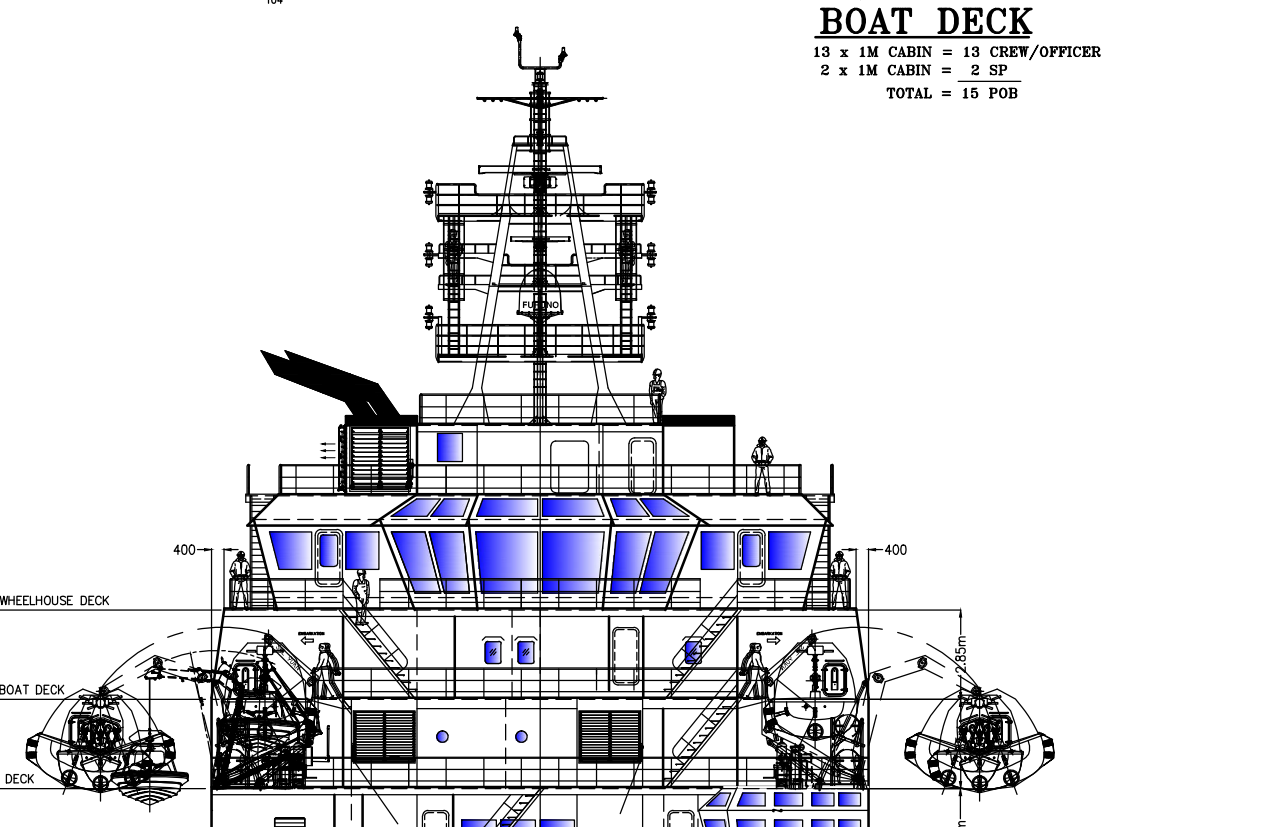
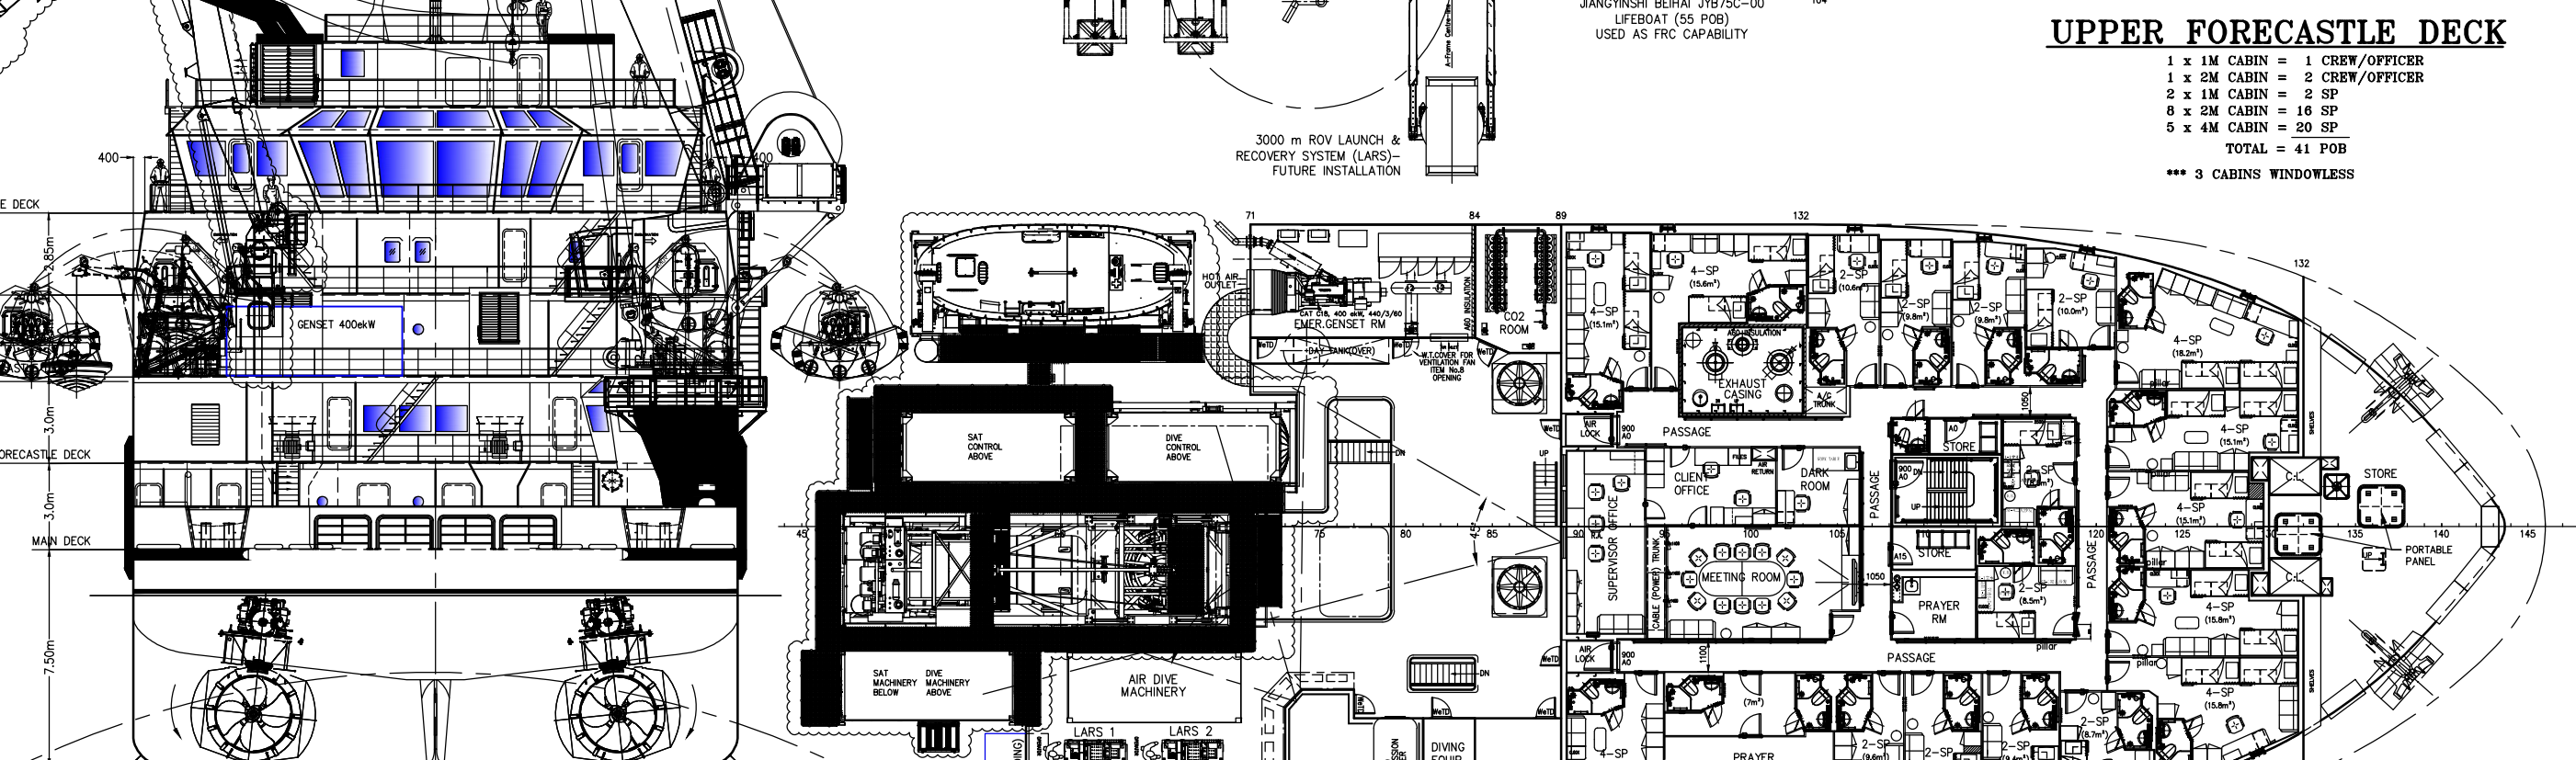
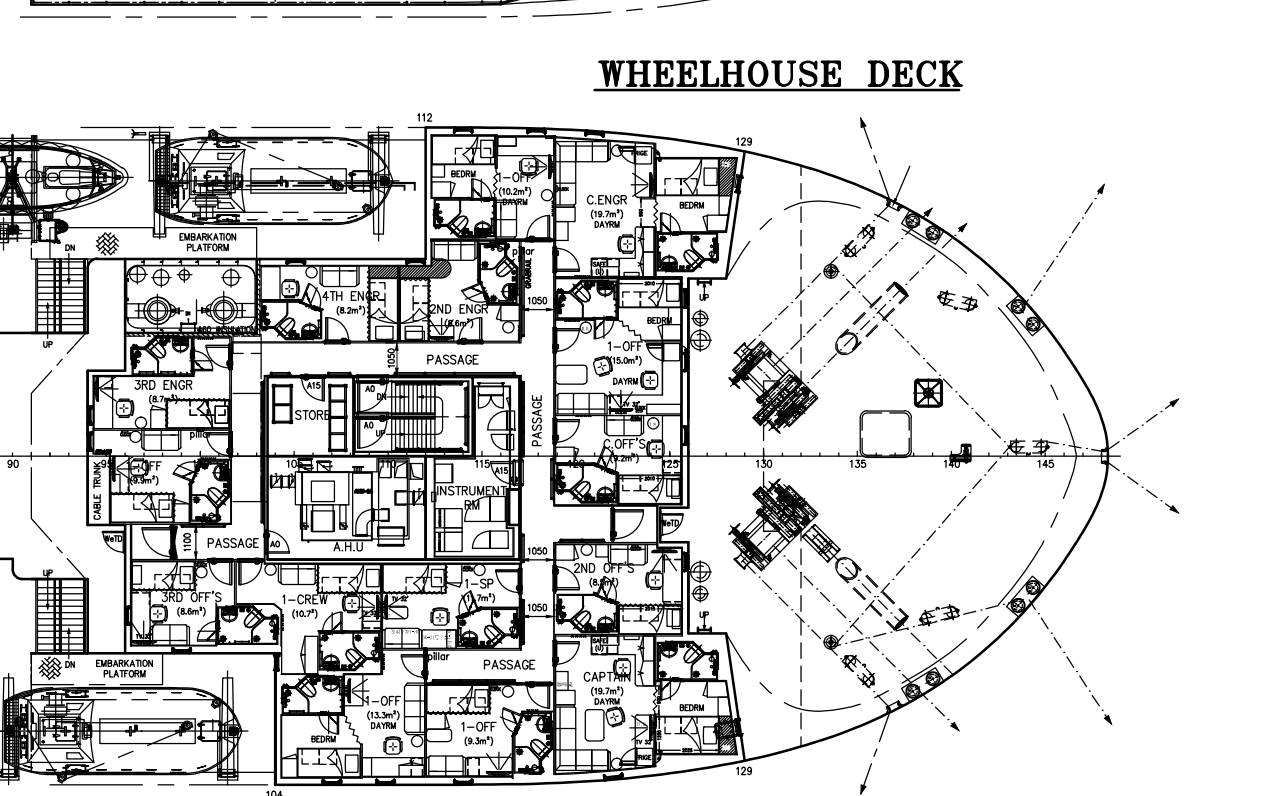
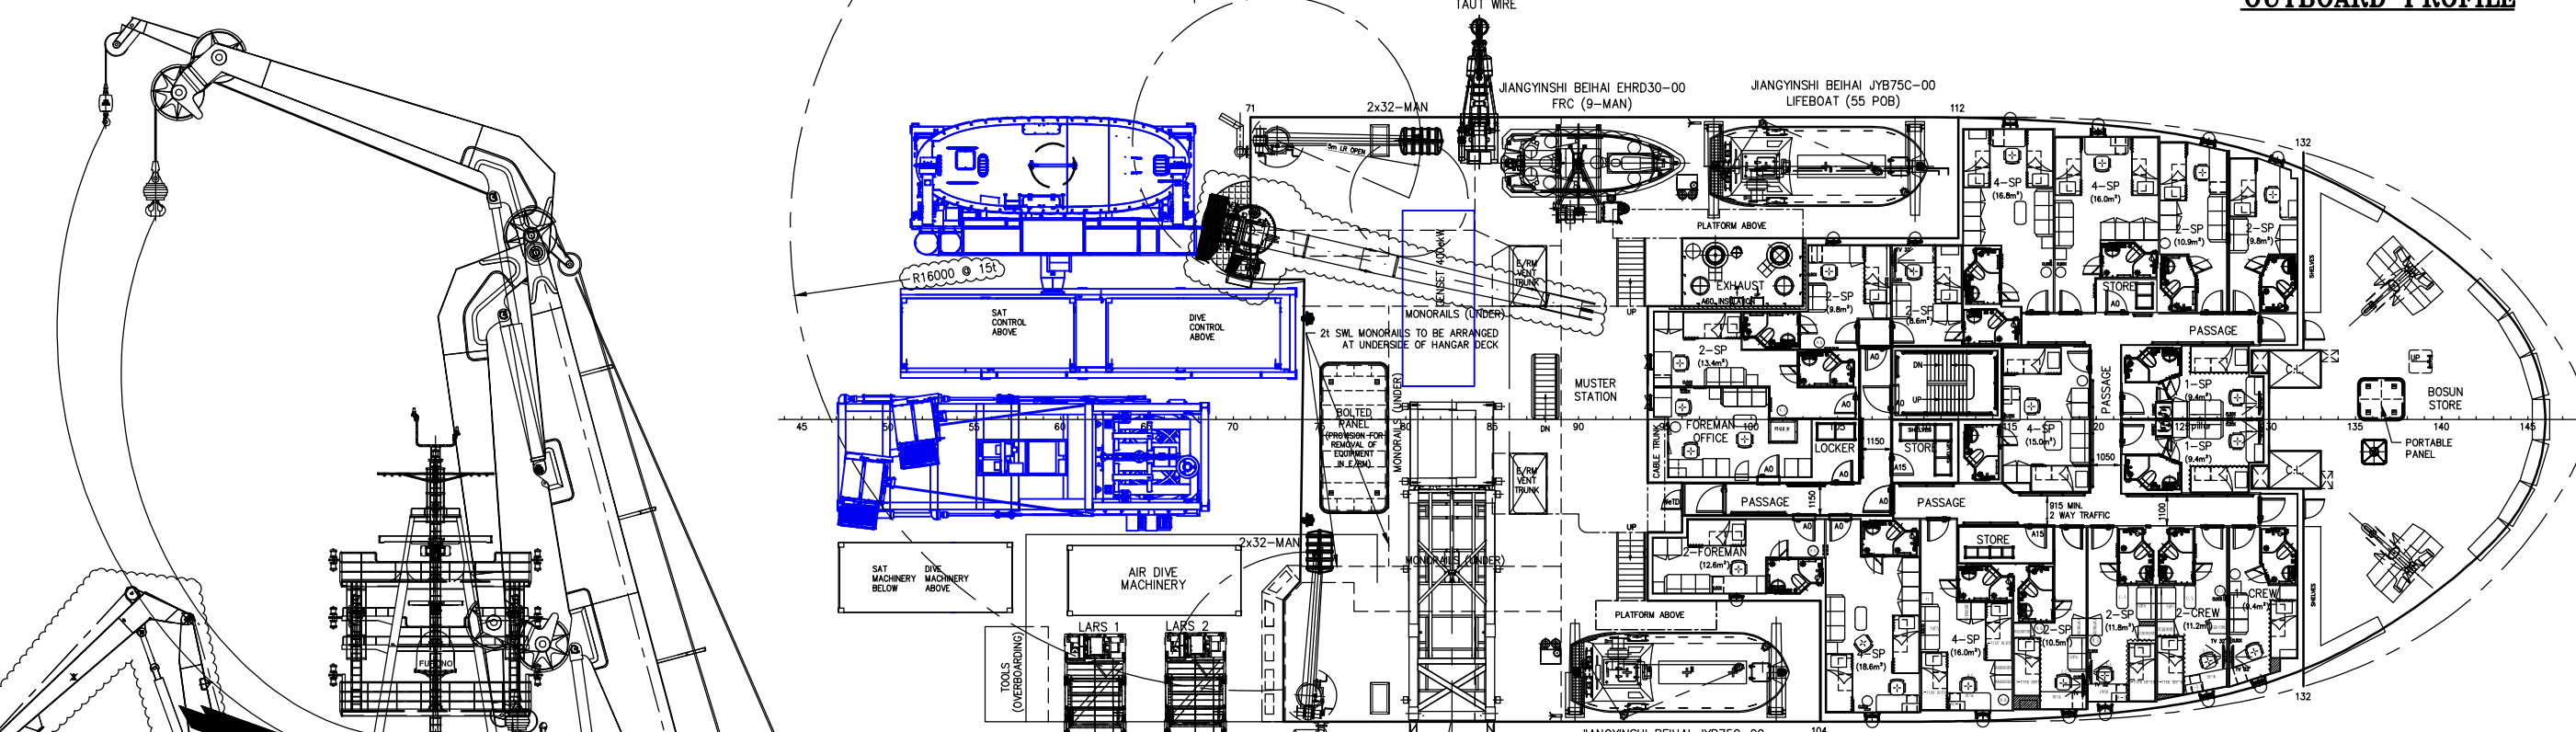
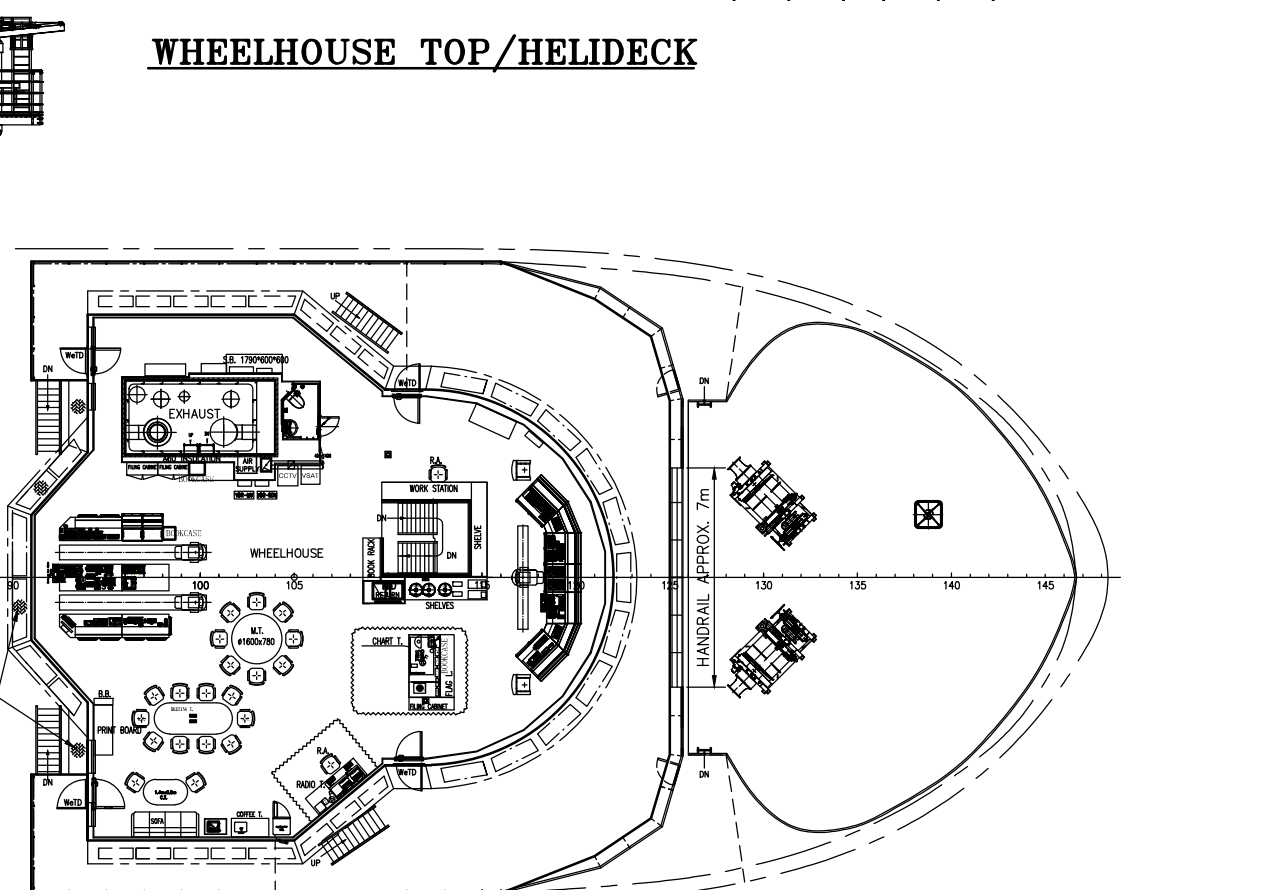
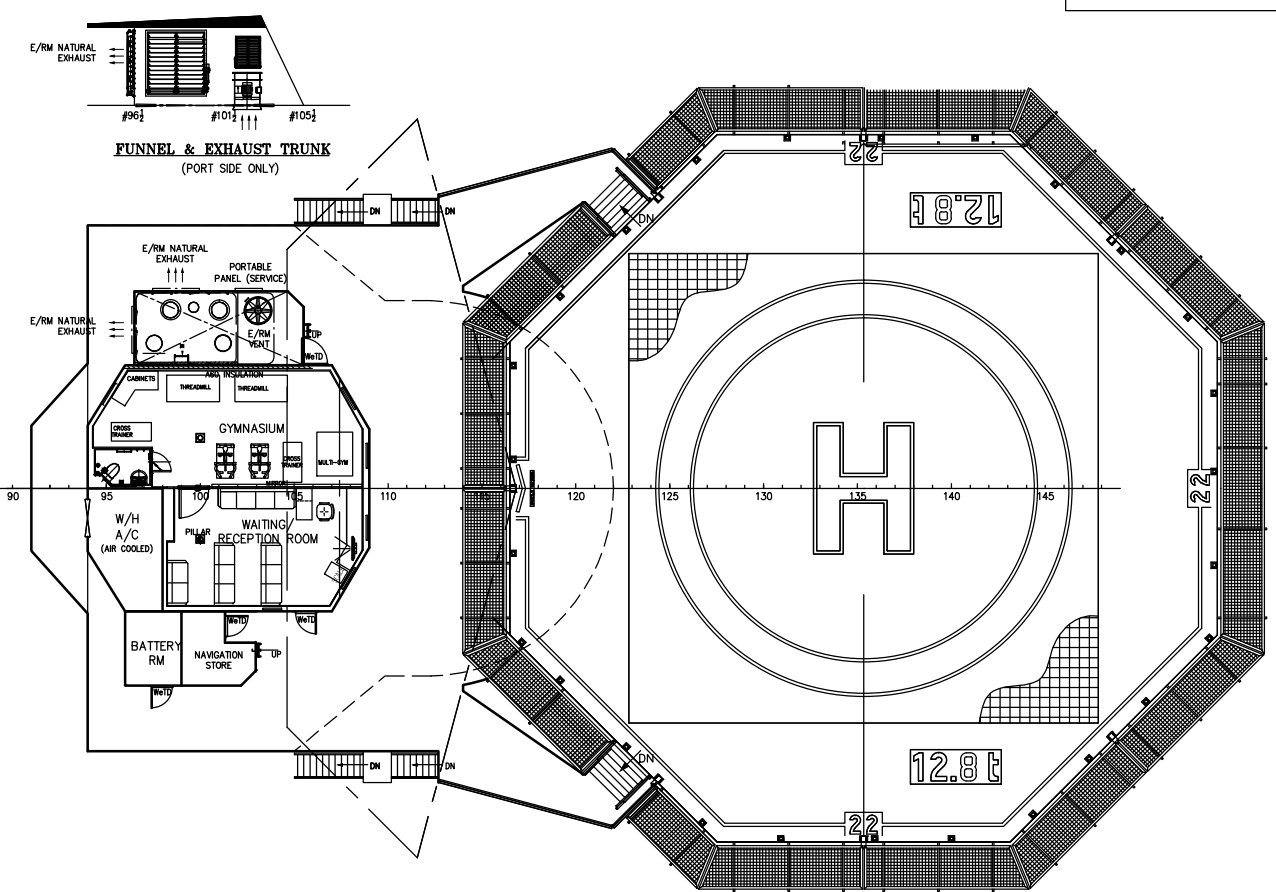


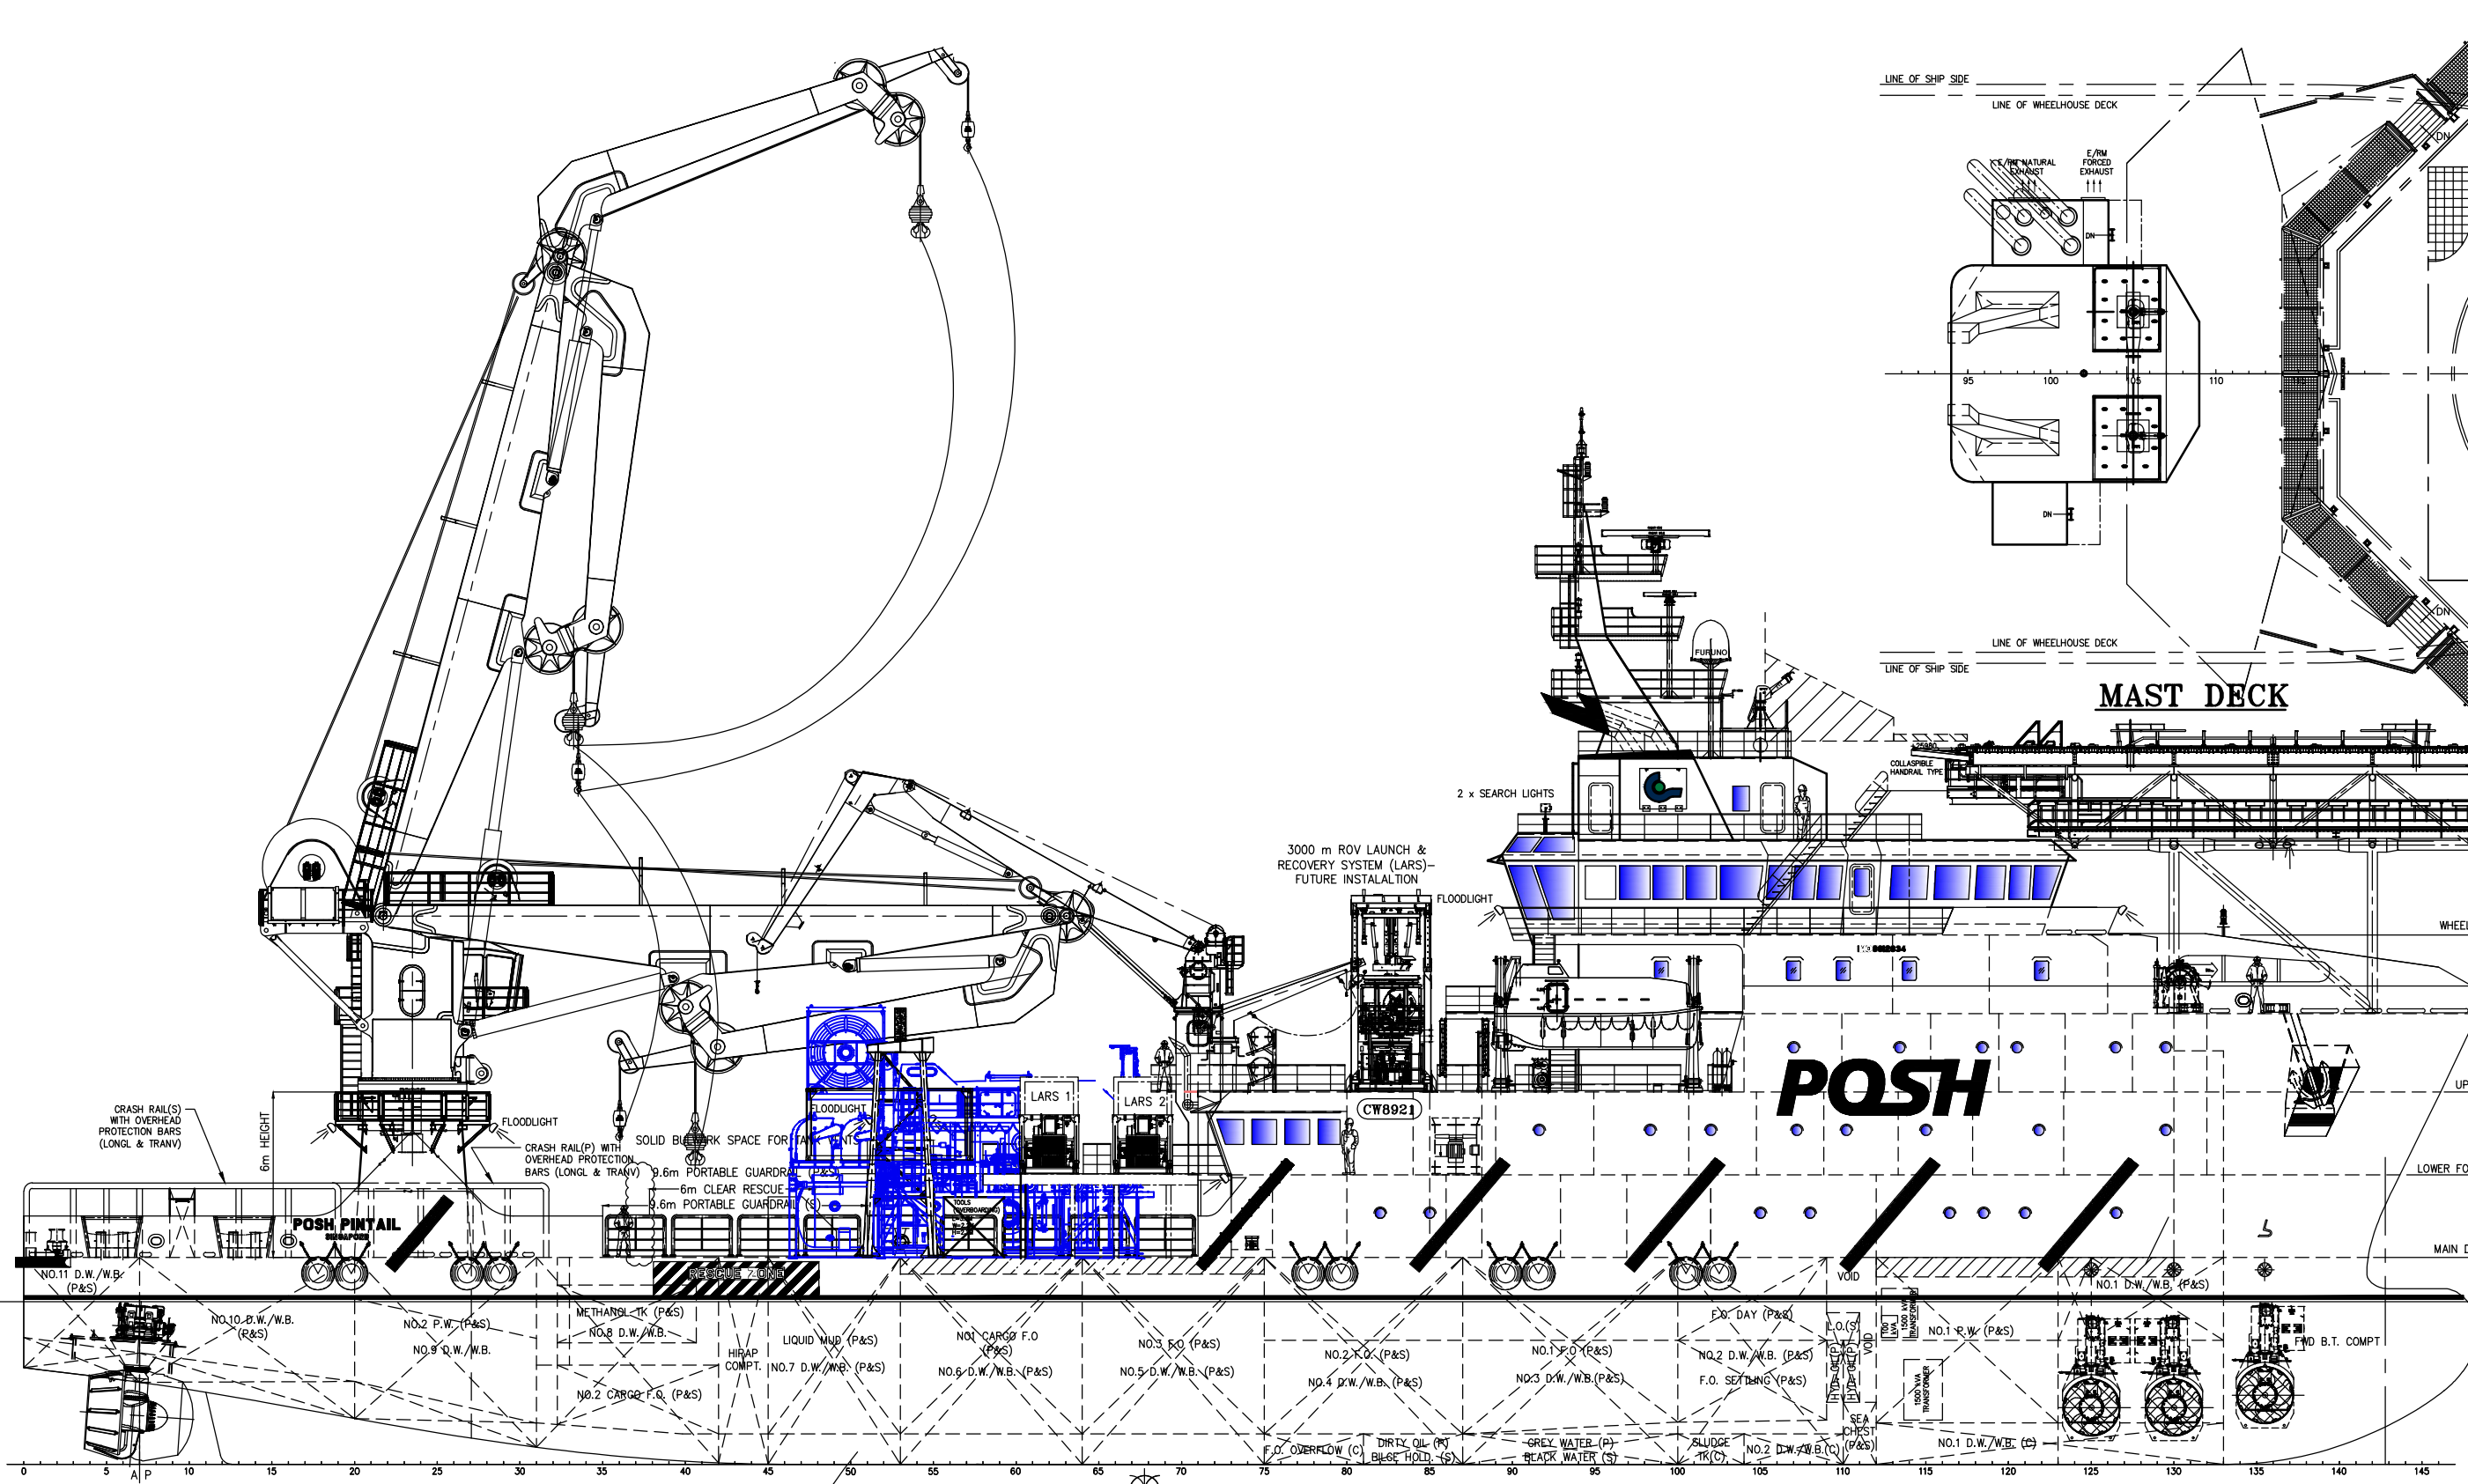

PARTICULARS			
GENERAL:			
LENGTH OVERALL	89.00 m (292.01 ft)		
LENGTH W.L.	85.67 m (281.08 ft)		
LENGTH B.P.	81.47 m (267.30 ft)		
BEAM MOULDED	21.00 m (68.90 ft)		
DEPTH MOULDED	7.50 m (24.61 ft)		
DRAFT DESIGNED / MAX.	5.90 m (19.35 ft)		
ACCOMMODATION (SPS)	108 POB (15x1 CREW + 1x2CREW +3x1 SP + 18x2 SP + 13x4 SP)		
TANK CAPACITIES: (approx.)			
FUEL OIL (SFO + CFO)	1000 m³ (EXCLUDE MOONPOOL)		
POTABLE WATER	1000 m³		
DRILL WATER / WATER BALLAST	2000 m³		
METHANOL	150 m³		
OPEN CLEAR DECK approx.	450 m² @ 7.5 t/m²		
OTHERS:			
MAIN DECK CRANE, KENZ KNUCKLE BOOM	120t @ 23.3m, MAX. 33m RADIUS		
AUXILIARY CRANE, KNUCKLE BOOM	4t @ 16m, MIN. 3.1m RADIUS		
HELIDECK (S-92), PANCAKE ALUM.	12.6t, 22m DIA.		
TOTALLY ENCLOSED LIFEBOATS	2 x 55-MAN		
FAST RESCUE CRAFT (FRC)	1 x 9-MAN, 20 knots WITH 3 POB		
MOONPOOL	4.2 m x 4.2 m		
SAT DIVE SYSTEM	12 MEN 300m MODULAR TYPE		
DATE	MODIFICATION	REV	BY
09.02.20	UPDATE AS PER DESIGN		M DWK
11.11.19	UPDATE AND FEEDBACK FROM POSH		L ANS
11.11.19	UPDATE AND FEEDBACK FROM POSH		K ANS
11.08.19	UPDATE AND FEEDBACK FROM POSH		J ANS
0.09.19	FEEDBACK FROM POSH		H DWK
05.09.19	FEEDBACK FROM POSH		G ANS
27.08.19	UPDATED FOR EXTENDING LOWER F'OLE DK. & MOONPOOL BAFFLE TKS.		F ANS
9.08.19	UPDATED FOR LARS AND KELLY TUBES SIZES, & OTHERS		E ANS
23.07.19	UPDATED FOR DRY CONVERSION.		D ANS
25.03.18	AS-BUILT DRAWING		Z WM
SHIP: 89m DP2 MULTI-PURPOSE SUPPORT VESSEL			
TITLE: GENERAL ARRANGEMENT			
OWNER	PACC OFFSHORE SERVICES HOLDINGS LIMITED (POSH)		YARD NO.
BUILDER	PACCOCEAN ENGINEERING ZHOUSHAN CO. LTD.		H1006
CLASS	ABS, A1, OFFSHORE SUPPORT VESSEL (SUPPLY, FFY 1) (DSV SAT, AIR), (ROV CAPABLE), (E), SPS, +AMS, +ACCU, DPS-2, ENVIRO, UWLID, MLC-ACCOM, CRC, HELIOL, SKP, GP		
CONAN WU ENTERPRISES PTE LTD			
19 TANGLIN ROAD, #09-07 TANGLIN SHOPPING CENTRE, SINGAPORE 247909			
TEL: (65) 6737-3707 FAX: (65) 6737-2637, E-MAIL: conanwu@conanwu.com.sg			
DRAWN	CHECKED	APPROVED	SCALE
VANESSA	CHUA		1:250
05.05.14	05.05.14		
DRAWING NO.		REV	
CW8921/G-1		M	